



EXISTING SIGNALS

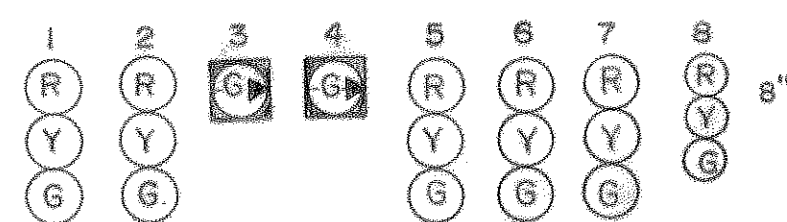

PHASE	1	2	3	4	5	6	7	8	9
PHASE 1	G	G	G	G	R	R	R	G	FL/OP
1 CHANGE	Y	Y	G	G	R	R	R	Y	
PHASE 2	R	R	G	G	G	G	G	R	
2 CHANGE	R	R	G	G	Y	Y	Y	R	
FLASHING	FL/Y	FL/Y	G	G	FL/R	FL/R	FL/R	FL/Y	
OPERATION	FL/Y	FL/Y	G	G	FL/R	FL/R	FL/R	FL/Y	

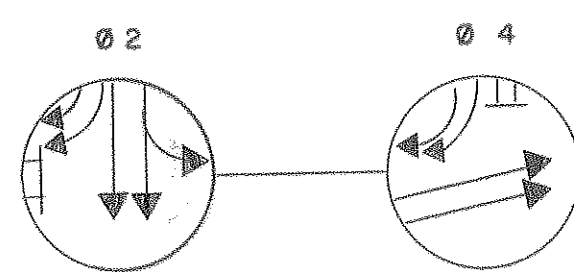


NOTE:

1). ORIGINAL PLAN IS ON FILE IN B.T.E.

LEGEND
OF UNDERGROUND UTILITIES

	GAS MAIN
	WATER MAIN
	SEWER MAIN
	ELECTRIC CABLES
	TELEPHONE CABLES
	AERIAL CABLES

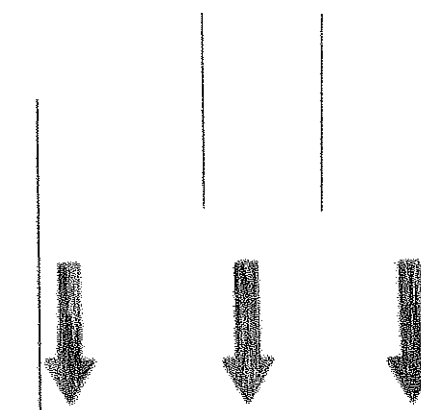MD 528
(PHILADELPHIA AVE.)

L SIGNAL NO. 23067

APPROVAL: CHIEF SIGNAL DESIGN
SECTIONAPPROVAL: REGIONAL
TRAFFIC ENGINEERAPPROVAL: CHIEF-BUREAU
OF
TRAFFIC ENGINEERINGAPPROVAL: ASST. CHIEF ENGINEER
TRAFFIC

4-5-83
REDRAWN & ASBUILT
WO-594-501-185
LS

REVISIONS

STATE OF MARYLAND
DEPARTMENT OF TRANSPORTATION
STATE HIGHWAY ADMINISTRATION

TRAFFIC DIVISION - BUREAU OF TRAFFIC ENGINEERING
MD 528 (PHILADELPHIA AVE) AT US 50,
NORTH DIVISION ST & CAROLINE ST

OCEAN CITY 'A' SYSTEM

SCALE: 1"=20' DATE: 4-5-83 CONTRACT NO.: AW-528-506-185

DRAWN BY: J. SPENCE / SR COUNTY: WORCESTER

DESIGNED BY: S. RENZI SIGNAL NO.: 23067

CHECKED BY:

DRAWING NO.

TS-140F